
# INSTALLED–WIRING DOCUMENTATION

## Custom Aftermarket Car Center Console Upgrade

I planned the circuit before construction. This October 2026 drawing documents my completed panel.
Dashed routes and the controller pin arrangement are illustrative; hidden connections are not verified.

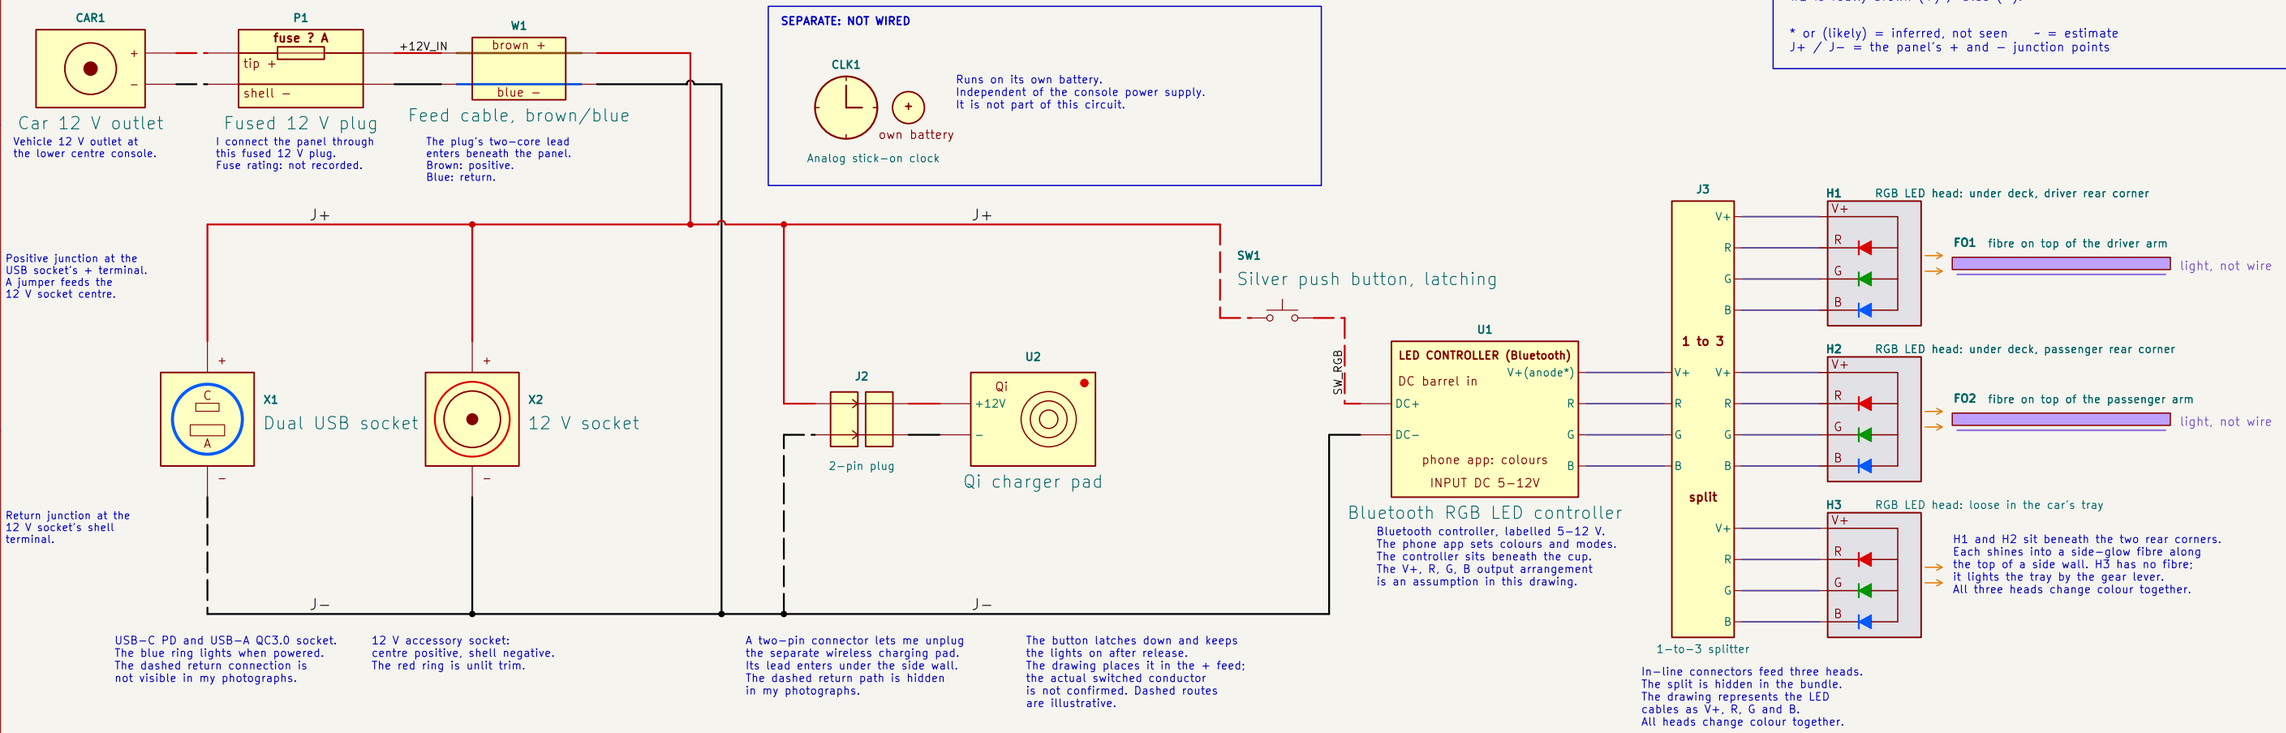


### LEGEND

- solid = seen in photos
- dashed = inferred
- purple = LED cables (V+, R, G, B)
- red = + side
- black = – side

Red / black / purple are drawing colours, not the real wire colours:
W1 is really brown (+) / blue (–).

* or (likely) = inferred, not seen  ~ = estimate
J+ / J– = the panel's + and – junction points

### HOW IT WORKS (plain words)

1. POWER. The fused cigarette plug P1 (fuse value unknown) is the panel's only power input. Its own lead is the two–wire cable W1 (brown = +, blue = –), which enters under the deck at the notch corner. The drawing connects P1 to the car outlet; its behavior with the car switched off needs checking.
2. J+ AND J–. Under the deck everything joins at two points: J+ (on the USB socket's + tab) and J– (on the 12 V socket's shell tab). The red and black branches split off in heat–shrunk joints beside the socket plate (3502).
3. SOCKETS. The USB socket X1 and the 12 V socket X2 are wired straight across J+ and J–, so they work whenever the car outlet is live.
4. WIRELESS CHARGER. The Qi pad U2 gets 12 V through a small two–pin plug J2.
5. LIGHTS. Press SW1: it latches down and keeps the RGB lights on after release. The drawing assumes SW1 interrupts the + feed to controller U1. U1 drives three RGB LED heads through the in–line plugs J3. A phone app sets the colours.
6. FIBRES. Heads H1 and H2 sit under the deck at the rear corners and shine into side–glow fibres FO1 and FO2, which run along the top of the two side arms. Head H3 has no fibre and lies loose in the car's tray by the gear lever.
7. CLOCK. It has its own battery and no wires.
8. CURRENT AT 12 V (approx.): USB up to 4–4.5 A, Qi pad 1.5–2 A, lights 0.5–1 A. About 7 A in total, before anything is plugged into the 12 V socket X2.
9. PROTECTION. Only the fuse in the plug tip and the car's own outlet fuse.

### CONNECTIONS AND RATINGS TO VERIFY

- The fuse value printed in the plug tip.
- Whether the car's outlet stays live with the car fully off.
- Continuity from plug P1 through cable W1 to the supply junctions.
- The button terminal routing and which wire it breaks (+ assumed in this drawing).
- The return route of the Qi pad's – wire, and of the USB socket's – tab.
- Whether the red and black wires in one connector (IMG_3422) share a circuit.
- What the small black cylinder with holes is, on a cable beside the slot bar (3502).

### ITEMS REQUIRING PHYSICAL INSPECTION

These observations identify checks to make on the real wiring; photographs cannot verify continuity.

WIRING AND CONNECTORS
- A red and a black wire share one lilac connector (IMG_3422): the colour code is broken.
- Two connectors on the 12 V socket's centre terminal (3482); one may sit on the stud (poor contact).
- One yellow connector on the USB socket body has no visible wire.
- Red wire ends at the button corner, one with a bare tip (IMG_3445, 3502): live if not in the button.
- Oversized blue connectors crimped on thin wire; some barrels hold two wires.

FUSE AND CABLE SIZES
- Verify the installed fuse value and actual conductor sizes.
- Check protection against the ratings of every conductor, connector and load.
- Wire sizes estimated from photographs are not sufficient for this check.

SAFETY AND PLACEMENT
- Bare 12 V centre stud and brass nut: a short if they touch the seat–belt buckle (car earth) when the panel is turned over on the seat.
- Cables and the loose LED head lie across the EV MODE, drive–mode and EPB/HOLD switches and the gear gate (3484); others run near the seat rails and buckle.
- Check that the wings do not block the seat–belt buckles or seat adjustment.
- If the outlet is live all the time, standby draw (controller, USB ring, Qi pad) slowly drains the car's small 12 V battery.

A proposed protection revision is on a separate sheet. It is not installed or validated.

### ABOUT THIS DRAWING

I designed the panel in 3D and planned its circuit before fabrication.
Then I cut, covered and wired it.
Photos document the completed panel and help verify this illustration.

This is a present–day explanatory drawing of the completed panel.
Use it with the physical photographs.
Dashed lines mark connections hidden in the evidence; values approximate.
Parts without library symbols are shown as labelled boxes.

Removable console panel; drawing documents the completed build
Solid wire = seen in photos, dashed wire = inferred; values approximate
Installed–wiring documentation; hidden connections are inferred
Date drawn: 2026–10–03
**Console design and build documentation**
Sheet: /
File: console_as_built.kicad_sch

***Title: Custom Aftermarket Car Center Console Upgrade – As–built***

| Size: A3 | Date: 2026–10–03 | **Rev: B** |
|---|---|---|
| KiCad E.D.A. 10.0.6 | | Id: 1/1 |